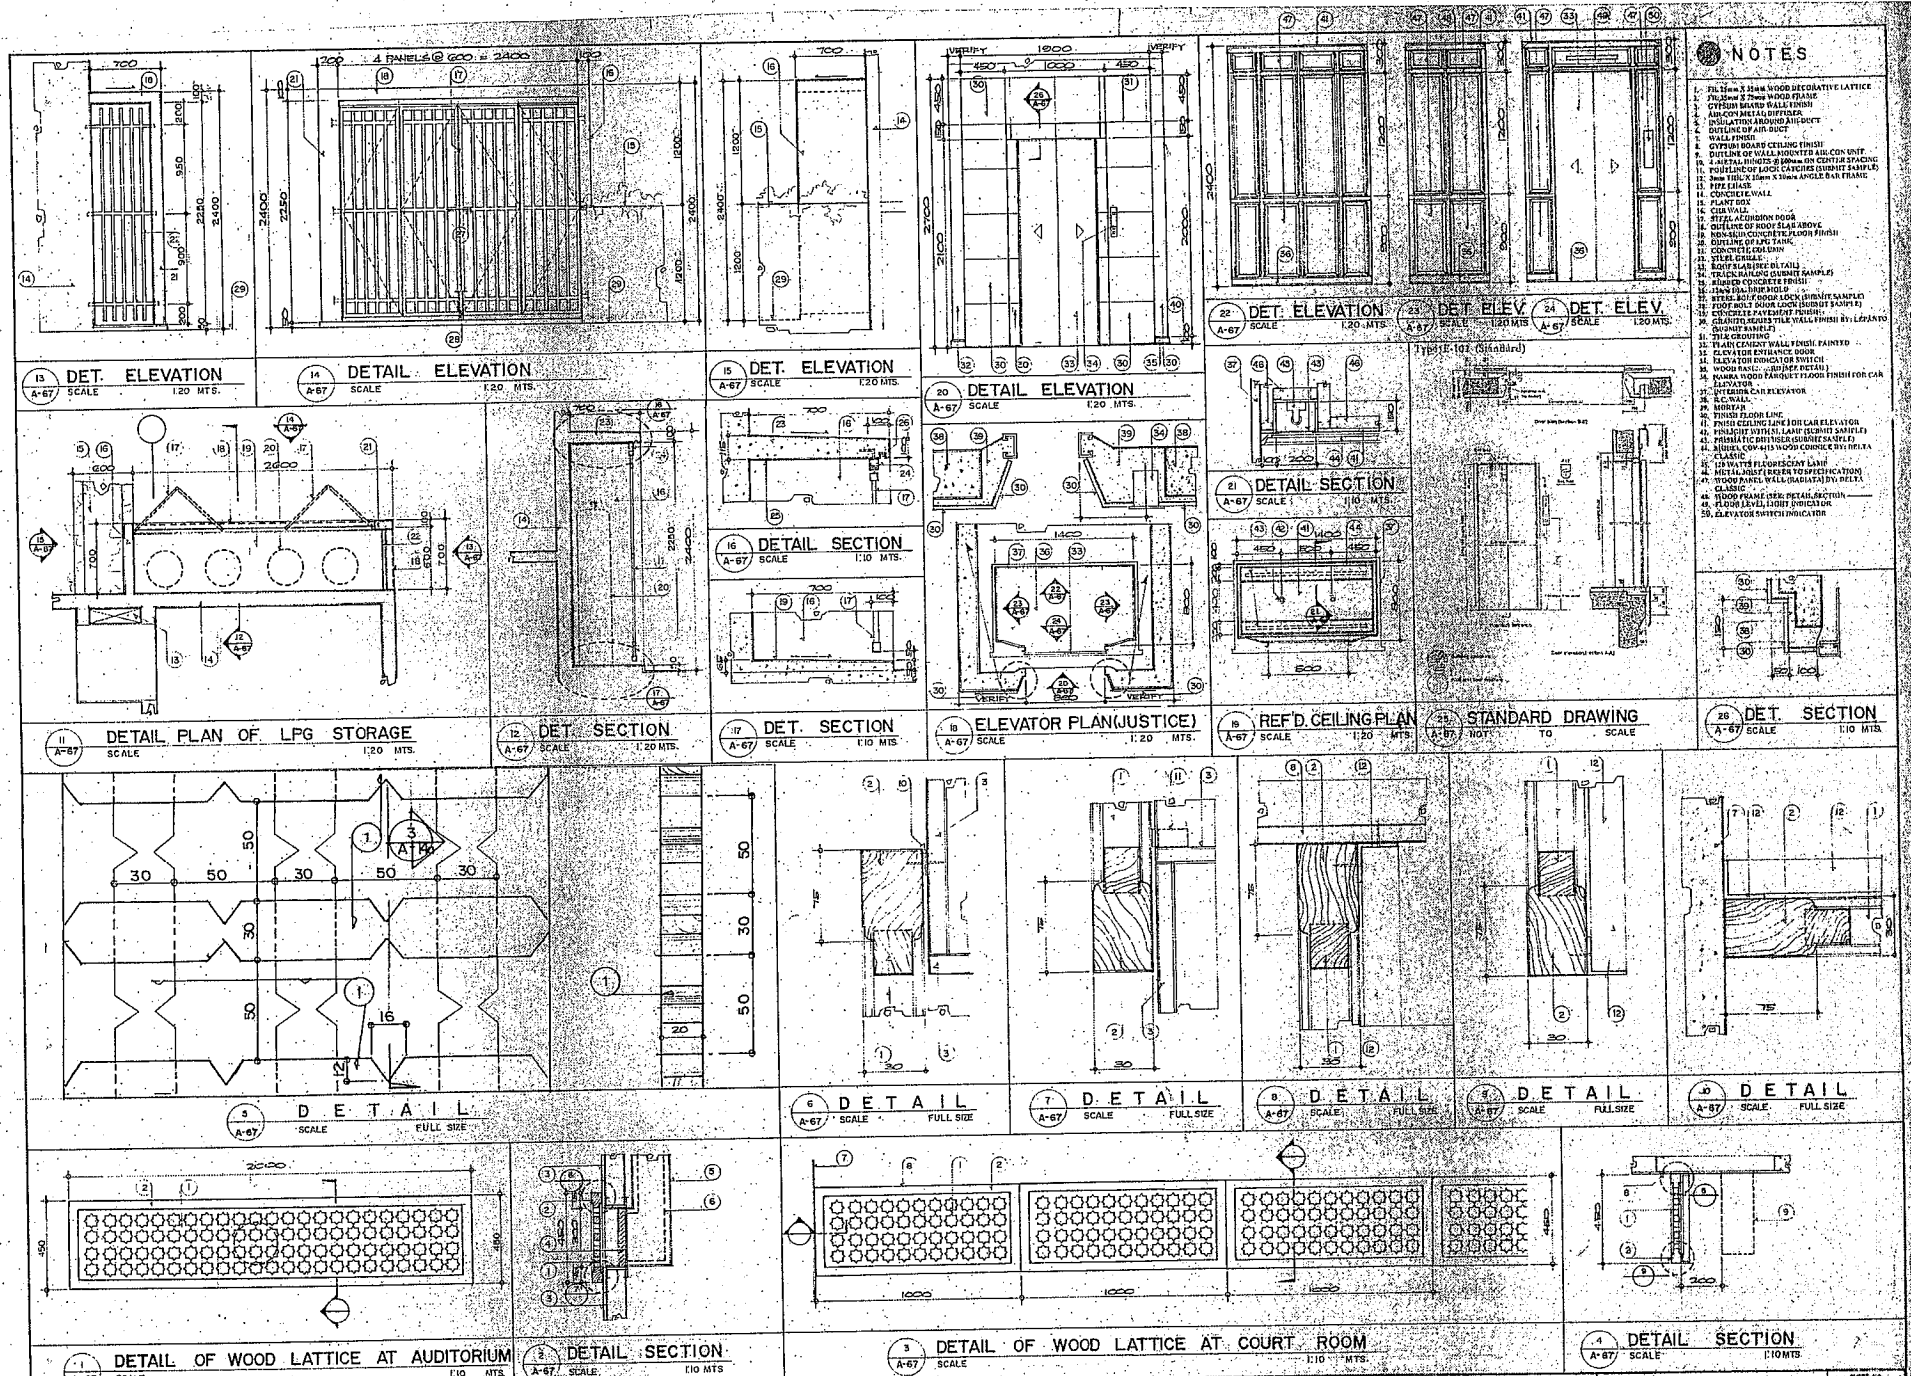

NOTES

1. FIL 25mm X 35mm WOOD DECORATIVE LATTICE
2. FIL 35mm X 75mm WOOD FRAME
3. GYPSUM BOARD WALL FINISH
4. AIR-CON METAL DIFFUSER
5. INSULATION AROUND AIR-DUCT
6. OUTLINE OF AIR-DUCT
7. WALL FINISH
8. GYPSUM BOARD CEILING FINISH
9. OUTLINE OF WALL MOUNTED AIR-CON UNIT
10. 4 METAL HINGES @ 600mm ON CENTER SPACING
11. POSITLINE OF LOCK CATCHES (SUBMIT SAMPLE)
12. 3mm THK X 10mm X 10mm ANGLE BAR FRAME
13. PIPE CHASE
14. CONCRETE WALL
15. PLANT BOX
16. CHR WALL
17. STEEL ACCORDION DOOR
18. OUTLINE OF ROOF SLAB ABOVE
19. NON-SKID CONCRETE FLOOR FINISH
20. OUTLINE OF LPG TANK
21. CONCRETE COLUMN
22. STEEL GRILLE
23. ROOF SLAB (SEE DETAIL)
24. TRACK RAILING (SUBMIT SAMPLE)
25. RUBBED CONCRETE FINISH
26. 15mm DIA. DRIP MOLD
27. STEEL BOLT DOOR LOCK (SUBMIT SAMPLE)
28. FOOT BOLT DOOR LOCK (SUBMIT SAMPLE)
29. CONCRETE PAVEMENT FINISH
30. GRANITE SEQUES TILE WALL FINISH BY: LEPANTO (SUBMIT SAMPLE)
31. TILE GROUTING
32. PLAIN CEMENT WALL FINISH PAINTED
33. ELEVATOR ENTRANCE DOOR
34. ELEVATOR INDICATOR SWITCH
35. WOOD BASE (SEE DETAIL)
36. NAMRA WOOD PARQUET FLOOR FINISH FOR CAR ELEVATOR
37. INTERIOR CAR ELEVATOR
38. R.C. WALL
39. MORTAR
40. FINISH FLOOR LINE
41. FINISH CEILING LINE FOR CAR ELEVATOR
42. FINLIGHT WITH SL LAMP (SUBMIT SAMPLE)
43. PRISMATIC DIFFUSER (SUBMIT SAMPLE)
44. MODEL COV-4115 WOOD CORNICE BY: DELTA CLASSIC
45. 120 WATTS FLUORESCENT LAMP
46. METAL JOIST (REFER TO SPECIFICATION)
47. WOOD PANEL WALL (RADIATA) BY: DELTA CLASSIC
48. WOOD FRAME (SEE DETAIL SECTION)
49. FLOOR LEVEL LIGHT INDICATOR
50. ELEVATOR SWITCH INDICATOR

PREPARED AND SUBMITTED BY:
HILMARC'S CONSTRUCTION CORPORATION
1835 E. RODRIGUEZ SR. AVENUE, QUEZON CITY
TEL. NOS. 828-4561 TO 64 : 922-7182 : 922-8338
FAX NO. : (632) 929-8311

CHECKED/RECEIVED BY:
FELIPE M. MENDOZA & PARTNERS

PEA - CONSTRUCTION TASK FORCE
BERNARDO T. VIRAY
PROJECT MANAGER PEA-CTF

PROJECT TITLE:
SANDIGANBAYAN CENTENNIAL BLDG.
COA COMPLEX, COMMONWEALTH AVE. CORNER BATASAN RD., QUEZON CITY

OFFICE OF THE PRESIDENT OF PHILIPPINES
PUBLIC ESTATES AUTHORITY
7TH FLOOR LEGASPI TOWERS 200, PASEO DE ROXAS, MAKATI CITY
RECOMMENDING APPROVAL: MANUEL R. BERRA JR. DEPUTY GEN. MANAGER DATE
APPROVED BY: CARLOS P. DOBLE GENERAL MANAGER DATE

AS BUILT PLAN

SHEET CONTENTS: DETAILS

SHEET NO. A-40

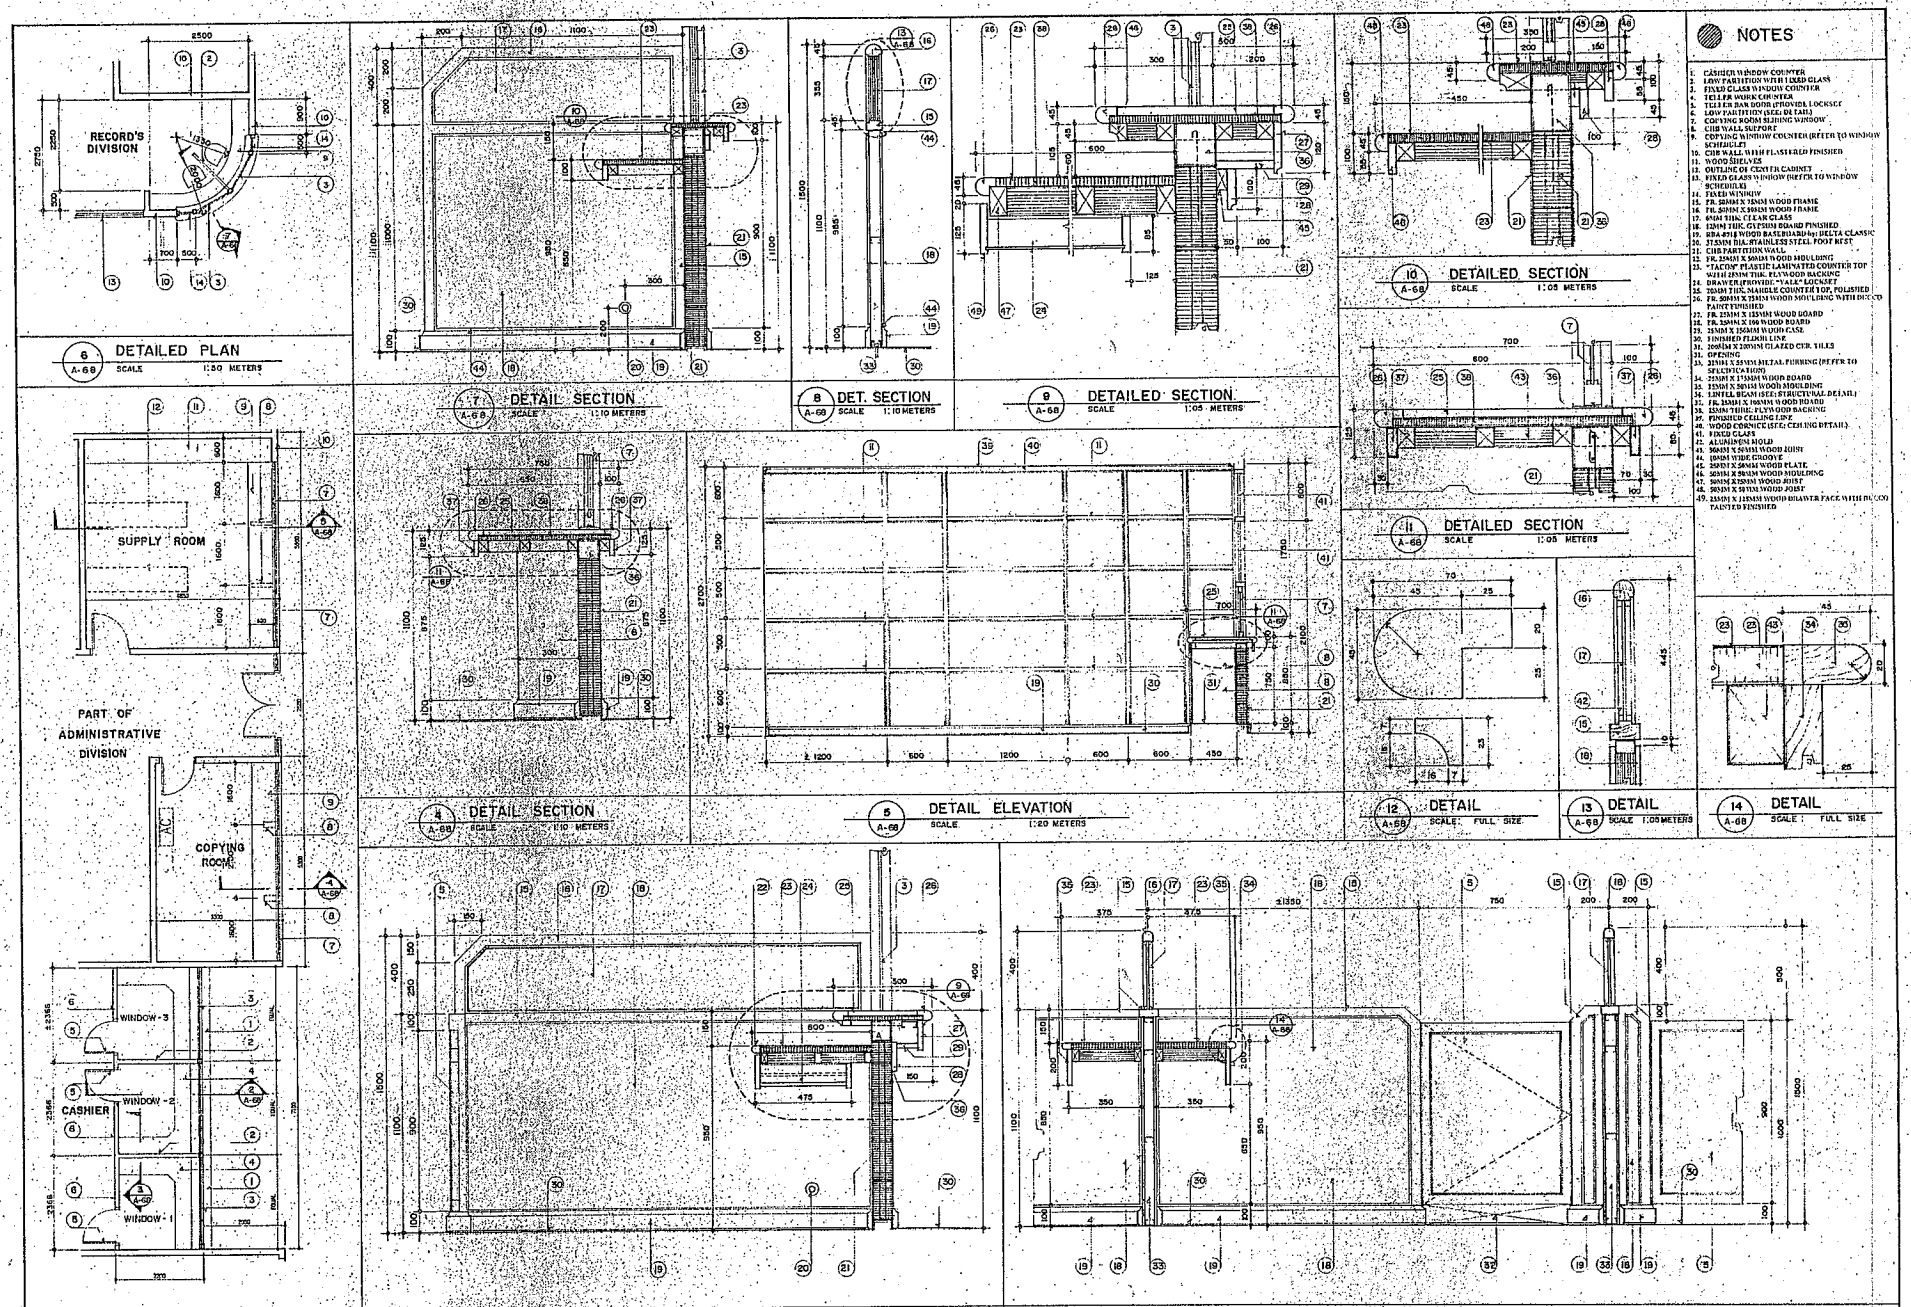

6 A-68 DETAILED PLAN SCALE 1:50 METERS

7 A-68 DETAIL SECTION SCALE 1:10 METERS

8 A-68 DET. SECTION SCALE 1:10 METERS

9 A-68 DETAILED SECTION SCALE 1:05 METERS

10 A-68 DETAILED SECTION SCALE 1:05 METERS

11 A-68 DETAILED SECTION SCALE 1:05 METERS

4 A-68 DETAIL SECTION SCALE 1:10 METERS

5 A-68 DETAIL ELEVATION SCALE 1:20 METERS

12 A-68 DETAIL SCALE: FULL SIZE

13 A-68 DETAIL SCALE 1:05 METERS

14 A-68 DETAIL SCALE: FULL SIZE

1 A-68 DETAILED PLAN SCALE 1:50 METERS

2 A-68 DETAIL SECTION SCALE 1:10 METERS

3 A-68 DETAIL SECTION SCALE 1:10 METERS

NOTES

1. CASHIER WINDOW COUNTER
2. LOW PARTITION WITH FIXED GLASS
3. FIXED GLASS WINDOW COUNTER
4. TELLER WORK COUNTER
5. TELLER BAR DOOR (PROVIDE LOCKSET
6. LOW PARTITION (SEE DETAIL)
7. COPYING ROOM SLIDING WINDOW
8. CHB WALL SUPPORT
9. COPYING WINDOW COUNTER (REFER TO WINDOW SCHEDULE)
10. CHB WALL WITH PLASTERED FINISHED
11. WOOD SHELVES
12. OUTLINE OF CENTER CABINET
13. FIXED GLASS WINDOW (REFER TO WINDOW SCHEDULE)
14. FIXED WINDOW
15. FR. 50MM X 75MM WOOD FRAME
16. FR. 50MM X 90MM WOOD FRAME
17. 6MM THK. CLEAR GLASS
18. 12MM THK. GYPSUM BOARD FINISHED
19. RBA-8918 WOOD BASEBOARD by: DELTA CLASSIC
20. 37.5MM DIA. STAINLESS STEEL FOOT REST
21. CHB PARTITION WALL
22. FR. 25MM X 50MM WOOD MOULDING
23. "TACON" PLASTIC LAMINATED COUNTER TOP WITH 25MM THK. PLYWOOD BACKING
24. DRAWER (PROVIDE "VALE" LOCKSET
25. 20MM THK. MARBLE COUNTER TOP, POLISHED
26. FR. 50MM X 75MM WOOD MOULDING WITH DUCCO PAINT FINISHED
27. FR. 25MM X 125MM WOOD BOARD
28. FR. 25MM X 100 WOOD BOARD
29. 25MM X 150MM WOOD CASE
30. FINISHED FLOOR LINE
31. 200MM X 200MM GLAZED CER. TILES
32. OPENING
33. 25MM X 55MM METAL FURRING (REFER TO SPECIFICATION)
34. 25MM X 175MM WOOD BOARD
35. 25MM X 50MM WOOD MOULDING
36. LINTEL BEAM (SEE STRUCTURAL DETAIL)
37. FR. 25MM X 100MM WOOD BOARD
38. 25MM THRU. PLYWOOD BACKING
39. FINISHED CEILING LINE
40. WOOD CORNICE (SEE CEILING DETAIL)
41. FIXED GLASS
42. ALUMINUM MOLD
43. 50MM X 50MM WOOD JOIST
44. 10MM WIDE GROOVE
45. 25MM X 50MM WOOD PLATE
46. 50MM X 50MM WOOD MOULDING
47. 50MM X 25MM WOOD JOIST
48. 50MM X 50MM WOOD JOIST
49. 25MM X 125MM WOOD DRAWER FACE WITH DUCCO PAINTED FINISHED

PREPARED AND SUBMITTED BY:

HILMARC'S CONSTRUCTION CORPORATION
1835 E. RODRIGUEZ SR. AVENUE, QUEZON CITY
TEL. NOS. 928-4581 TO 86 / 922-7443 / 922-8328
FAX NO.: (632) 929-8311

CHECKED/RECEIVED BY:

FELIPE M. MENDOZA & PARTNERS

PEA - CONSTRUCTION TASK FORCE

BERNARDO T. VIRAY
PROJECT MANAGER PEA-CTF

PROJECT TITLE:

SANDIGANBAYAN CENTENNIAL BLDG.
COA COMPLEX, COMMONWEALTH AVE., CORNER BATASAN RD., QUEZON CITY

OFFICE OF THE PRESIDENT OF PHILIPPINES
PUBLIC ESTATES AUTHORITY
7TH FLOOR LEGASPI TOWERS 200, PASEO DE ROXAS, MAKATI CITY
RECOMMENDING APPROVAL: APPROVED BY:

MANUEL R. BERRIA JR. DEPUTY GEN. MANAGER DATE
CARLOS P. DOBLE GENERAL MANAGER DATE

AS BUILT PLAN

SHEET CONTENTS: DETAIL 9

SHEET NO. A-41

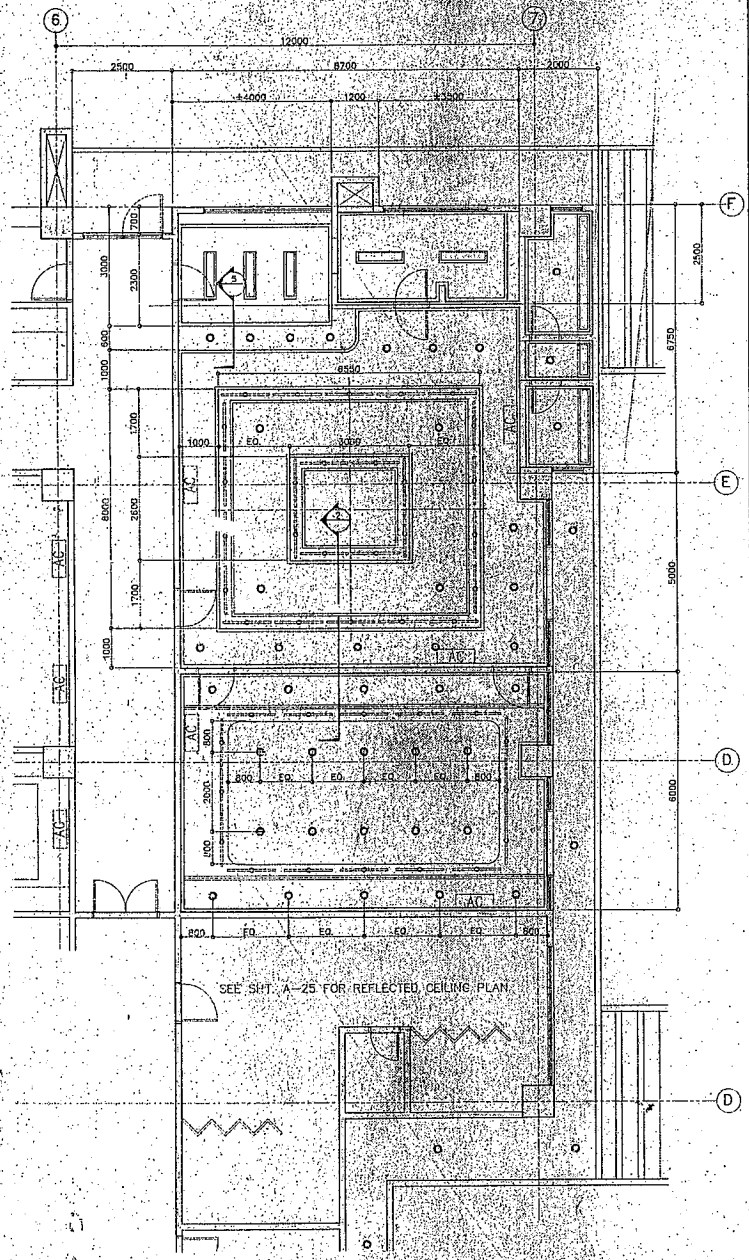

1 REFLECTED CEILING PLAN OF JUSTICE LOUNGE, CONFERENCE RM. & PANTRY
SCALE 1 : 50 MTS.

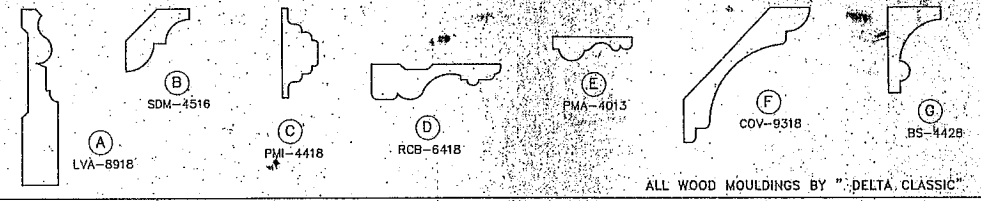

ALL WOOD MOULDINGS BY " DELTA, CLASSIC"

7 DETAIL OF WOOD MOULDING
SCALE FULL SIZE

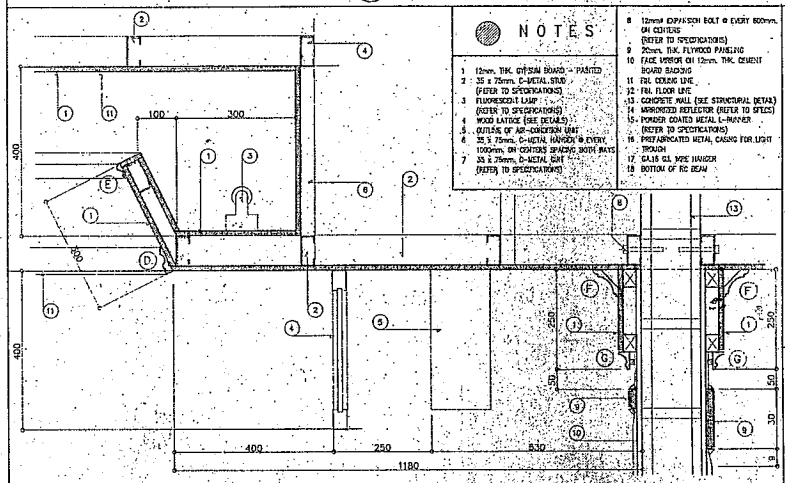

NOTES

1 12mm. THK. GYPSUM BOARD - PAINTED
2 : 35 x 75mm. C-METAL STUD : (REFER TO SPECIFICATIONS)
3 FLUORESCENT LAMP : (REFER TO SPECIFICATIONS)
4 WOOD LATTICE (SEE DETAILS)
5 OUTLINE OF AIR-CONDITION UNIT
6 35 X 75mm. C-METAL HANGER @ EVERY 1000mm. ON CENTERS BRACING BOTH WAYS
7 35 x 75mm. C-METAL SUPT (REFER TO SPECIFICATIONS)
8 12mm# EXPANSION BOLT @ EVERY 600mm. ON CENTERS (REFER TO SPECIFICATIONS)
9 20mm. THK. PLYWOOD PANELING
10 FACE MIRROR ON 12mm. THK. CEMENT BOARD BACKING
11 FIN. CEILING LINE
12 FIN. FLOOR LINE
13 CONCRETE WALL (SEE STRUCTURAL DETAIL)
14 MIRRORIZED REFLECTOR (REFER TO SPECS)
15 POWDER COATED METAL L-MOVER (REFER TO SPECIFICATIONS)
16 PREFABRICATED METAL CASING FOR LIGHT FIXTURE
17 GA.16 GI. WIRE HANGER
18 BOTTOM OF RC BEAM

3 TYPICAL DETAIL SECTION
SCALE 1 : 05 MTS.

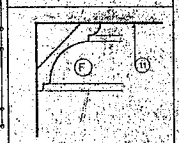

6 DET. SECT.
SCALE 1/2 FULL SIZE

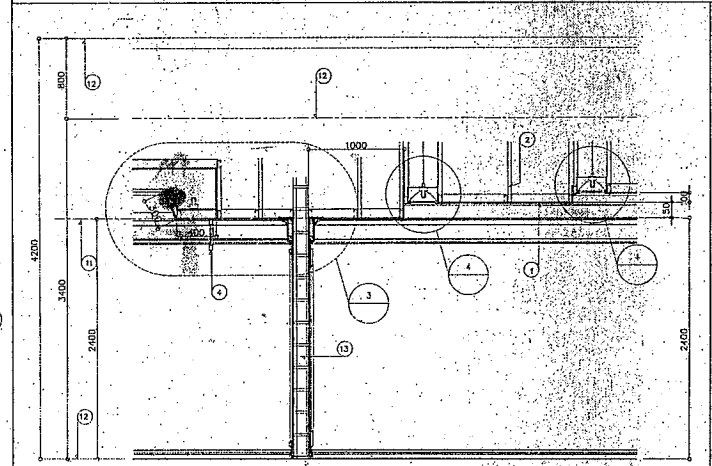

2 PARTIAL DETAIL SECTION OF JUSTICE LOUNGE & CONFERENCE ROOM
SCALE 1 : 20 MTS.

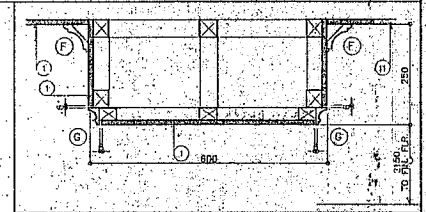

5 TYPICAL DETAIL SECTION
SCALE 1 : 05 MTS.

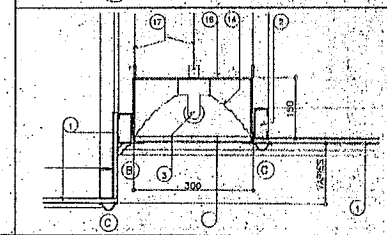

4 TYPICAL DETAIL SECTION
SCALE 1 : 05 MTS.

PREPARED AND SUBMITTED BY:
HILMARC'S CONSTRUCTION CORPORATION
1838 C. RODRIGUEZ SR. AVENUE, QUEZON CITY
TEL. NOS. 923-4981 TO 85 ; 923-7487 ; 923-8258
FAX NO. : (632) 924-8111

CHECKED/VERIFIED BY:
FELIPE M. MENDOZA & PARTNERS

PEA - CONSTRUCTION TASK FORCE
RODRIGO D. TEVAY
PROJECT MANAGER PEA-CTF

PROJECT TITLE / :
SANDIGANBAYAN CENTENNIAL BLDG.
CDA COMPLEX, COMMONWEALTH AVE. CORNER BATASAN RD., QUEZON CITY

OFFICE OF THE PRESIDENT OF PHILIPPINES
PUBLIC ESTATES AUTHORITY
7TH FLOOR LEGASPI TOWERS 200, PASEO DE ROXAS, MAKATI CITY
RECOMMENDING APPROVAL : MANUEL R. ECHEVERIA JR., DEPUTY GEN. MANAGER — DATE
APPROVED BY: CARLOS A. GONZALES, GENERAL MANAGER — DATE

AS BUILT PLAN

SHEET CONTENTS :
CEILING, PLAN & DETAILED SECTION

A-43
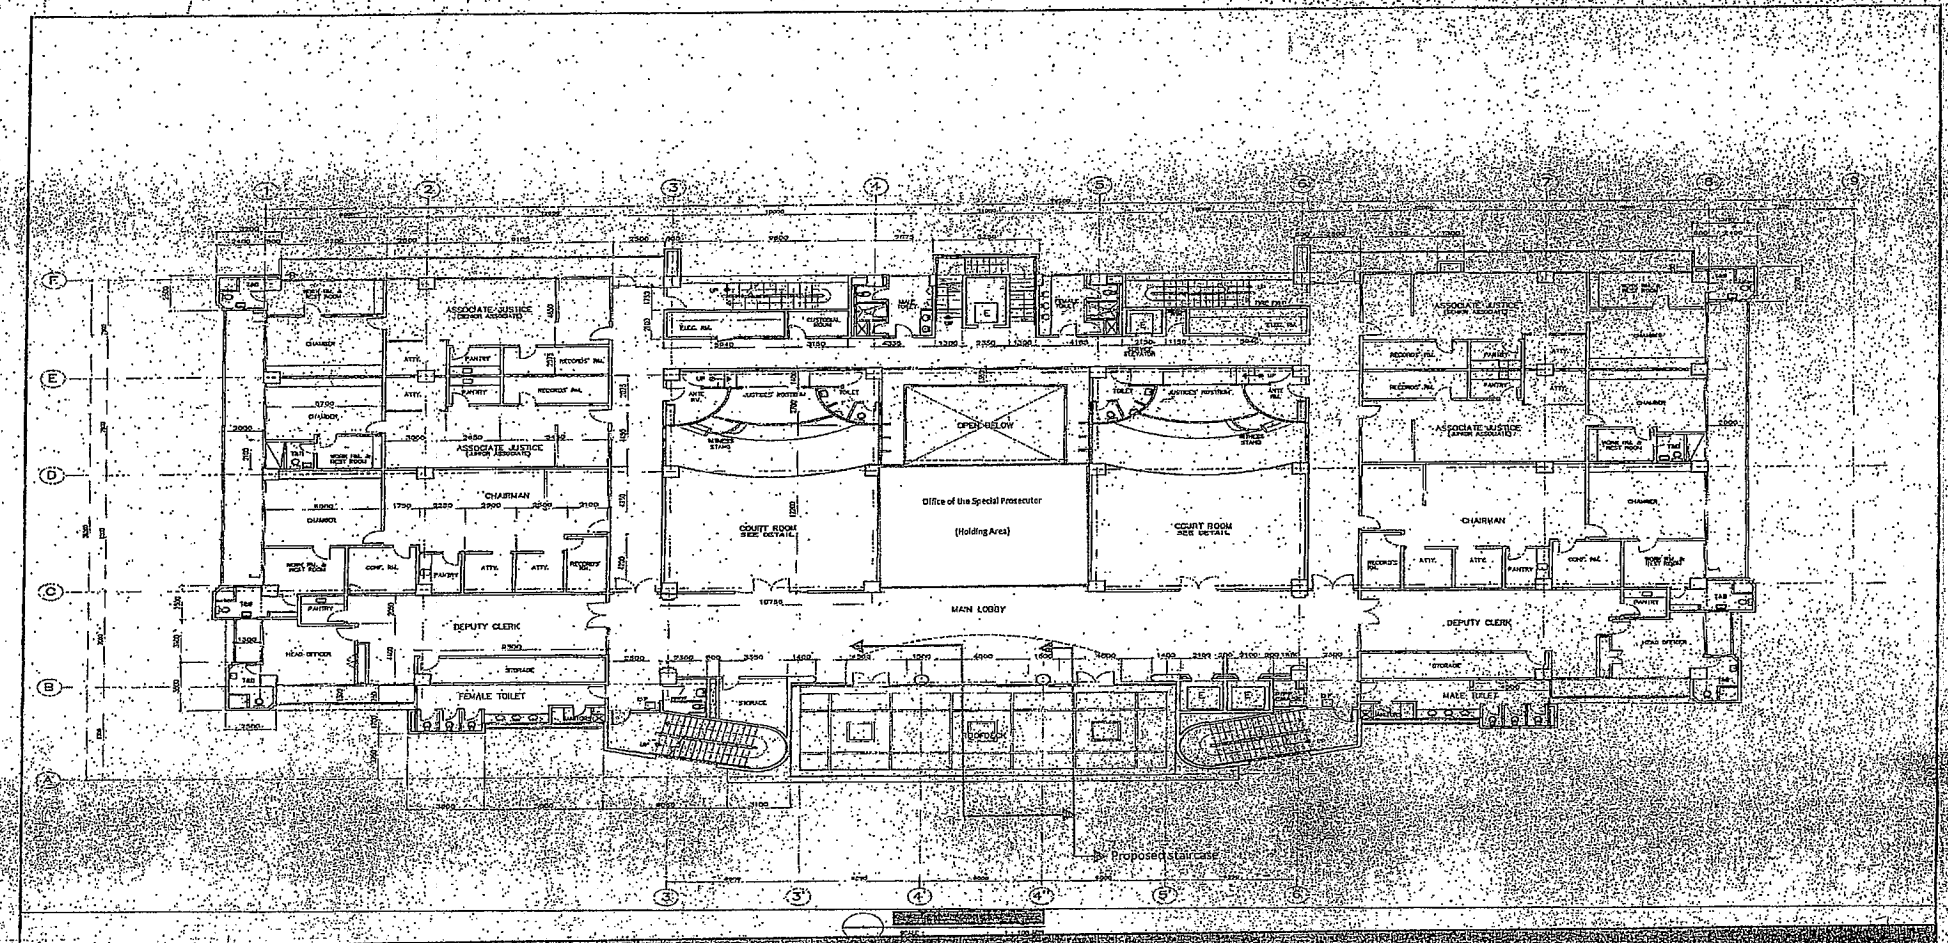
PROPOSED FIFTH FLOOR PLAN